





Express Mail No.: EV336512035US Deposited: 07/29/2003
Title: METHOD OF ATTACHING A FLORAL SLEEVE TO A POT
VIA BONDING MATERIAL
Inventors: Donald E. Weder
Filed: Herewith Group: 3644
Examiner: F. Palo
Agent: Christopher W. Corbett
SHEET 3 OF 22 Redline Drawings

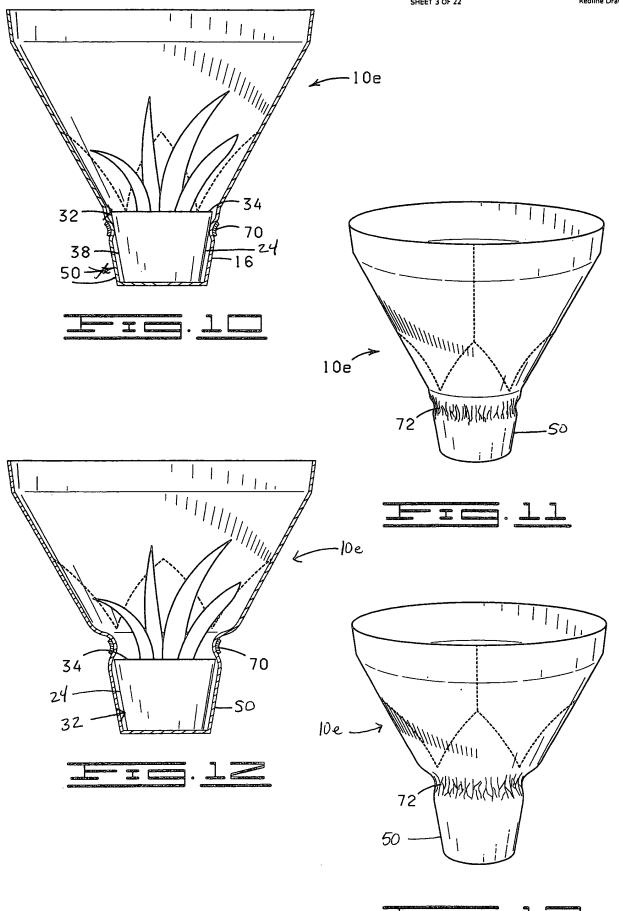



Express Mail No.: EV336512035US Deposited: 07/29/2003
Title: METHOD OF ATTACHING A FLORAL SLEEVE TO A POT
VIA BONDING MATERIAL
Inventors: Donald E. Weder
Filed: Herewith Examiner: F. Palo
Agent: Christopher W. Corbett Obt. No.: 8403.942
Redline Drawings

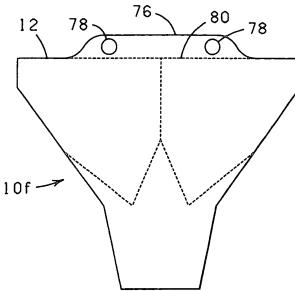

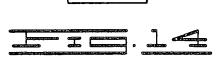


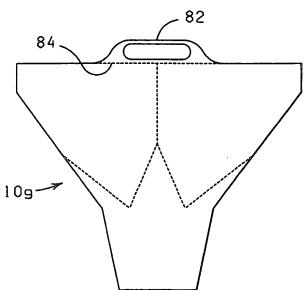


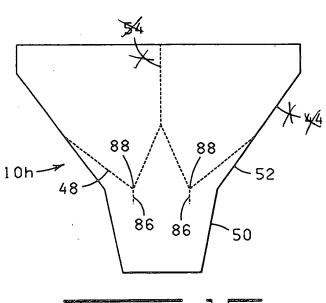


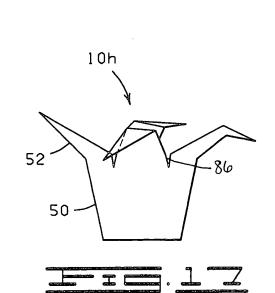



Express Mail No.: EV336512035US Deposited: 07/29/2003
Title: METHOD OF ATTACHING A FLORAL SLEEVE TO A POT
VIA BONDING MATERIAL
Inventors: Donald E. Weder
Filed: Herewith Examiner: F. Palo
Agent: Christopher W. Corbett
SHEET 5 OF 22 Redline Drawings

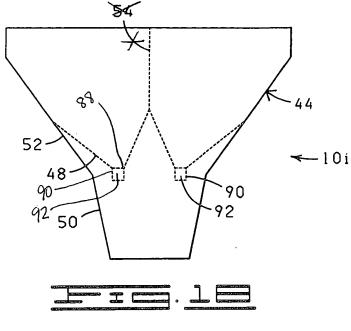


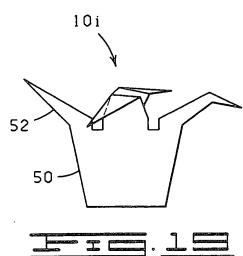

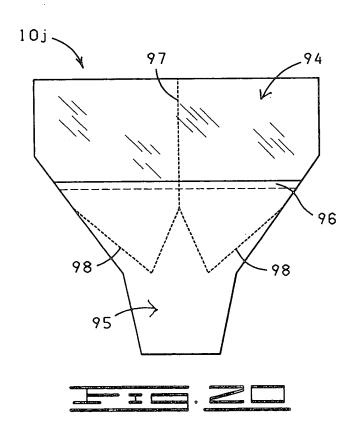

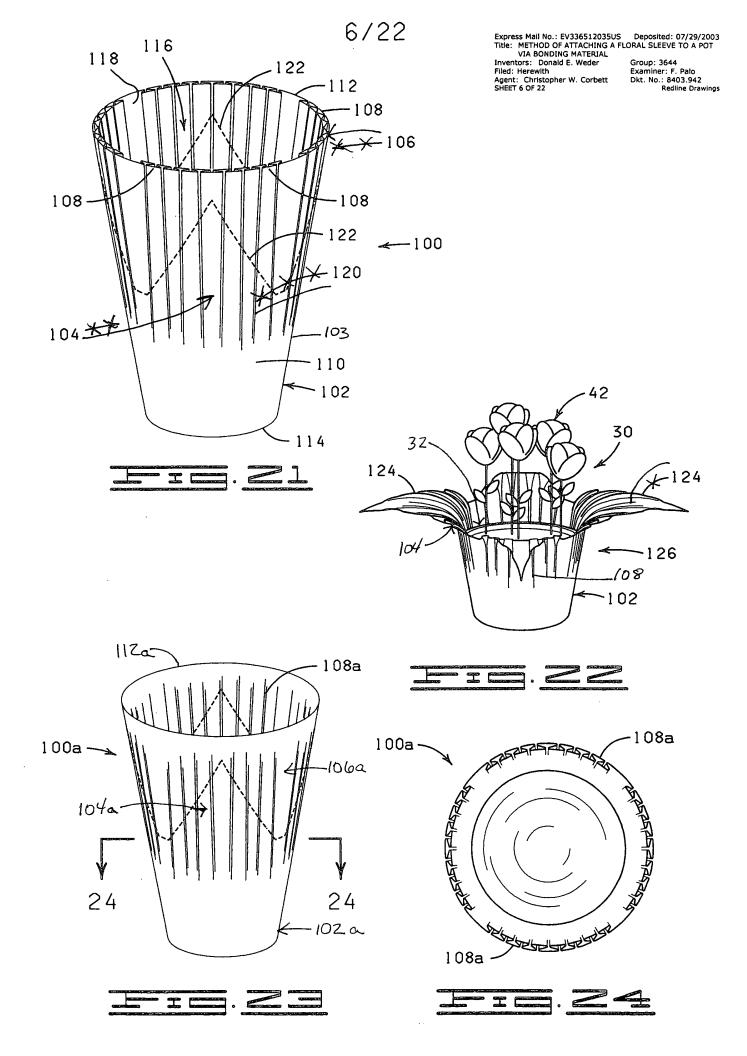

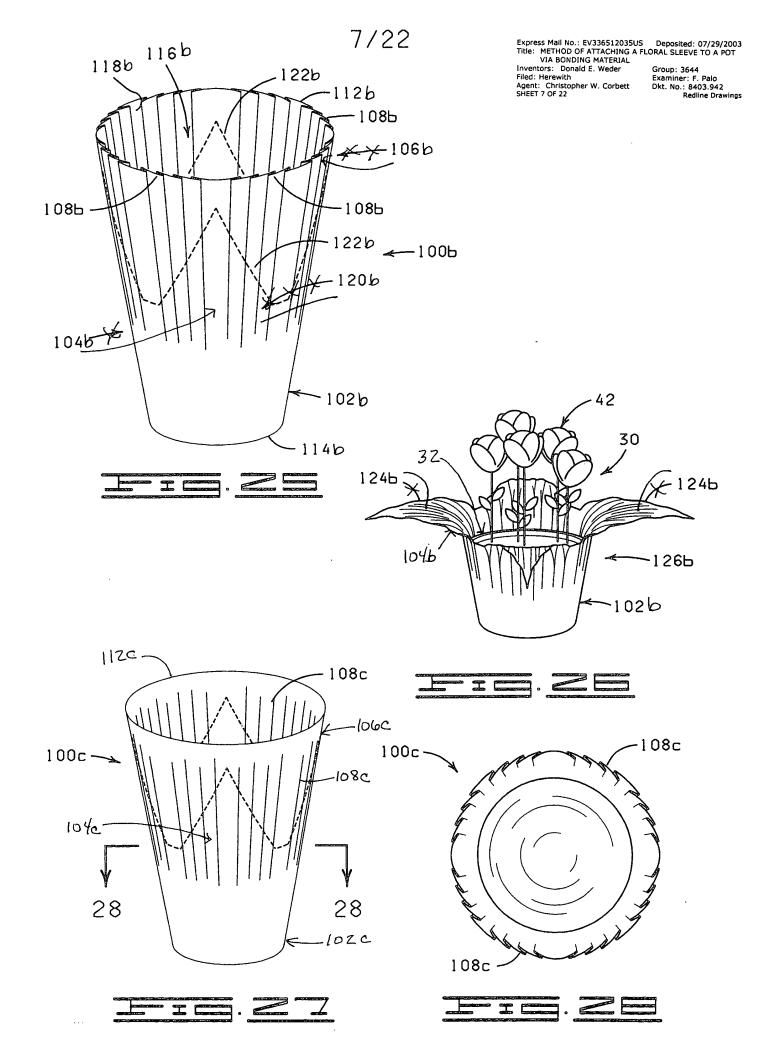


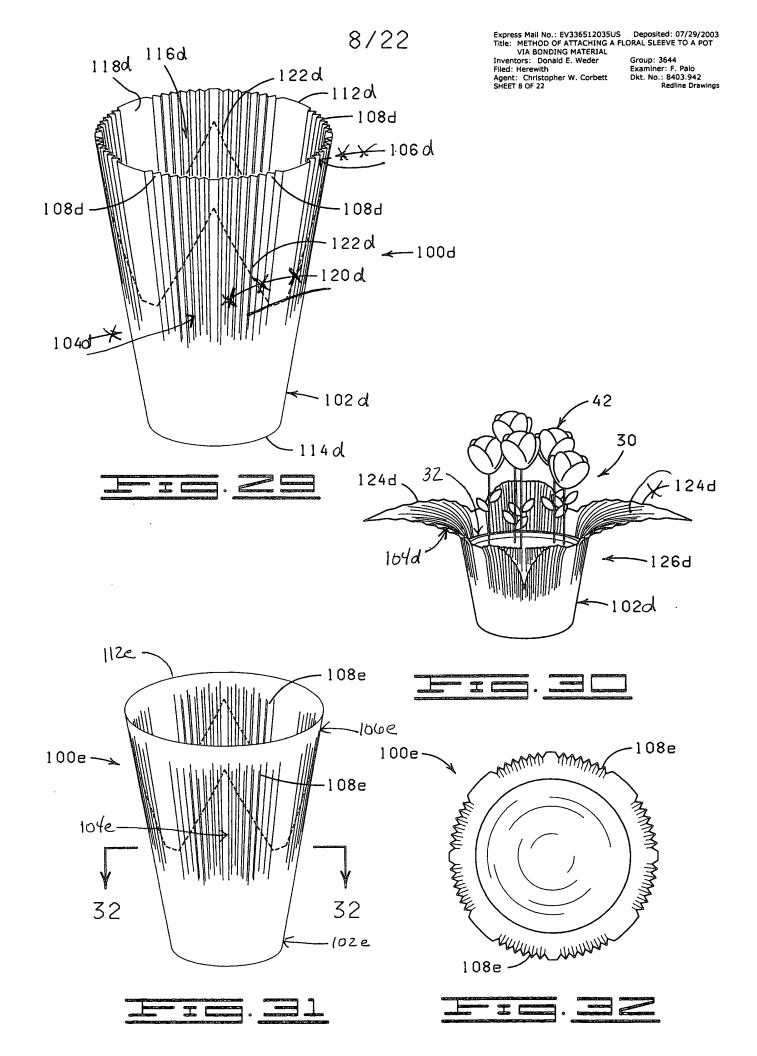



Express Mail No.: EV336512035US
Title: METHOD OF ATTACHING A FLORAL SLEEVE TO A POT VIA BONDING MATERIAL
Inventors: Donald E. Weder
Filed: Herewith
Agent: Christopher W. Corbett
SHEET 9 OF 22

Deposited: 07/29/2003


Group: 3644
Examiner: F. Palo
Dkt. No.: 8403.942
Redline Drawings

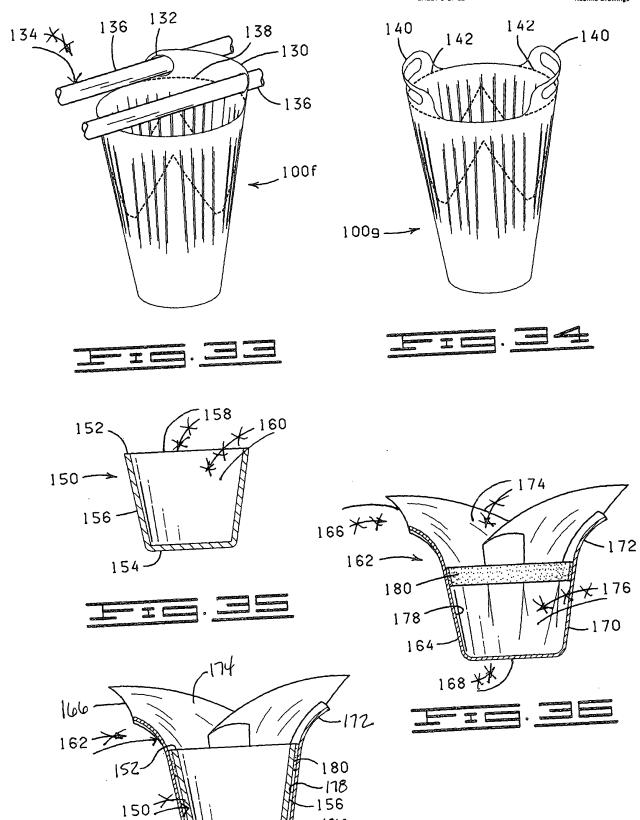


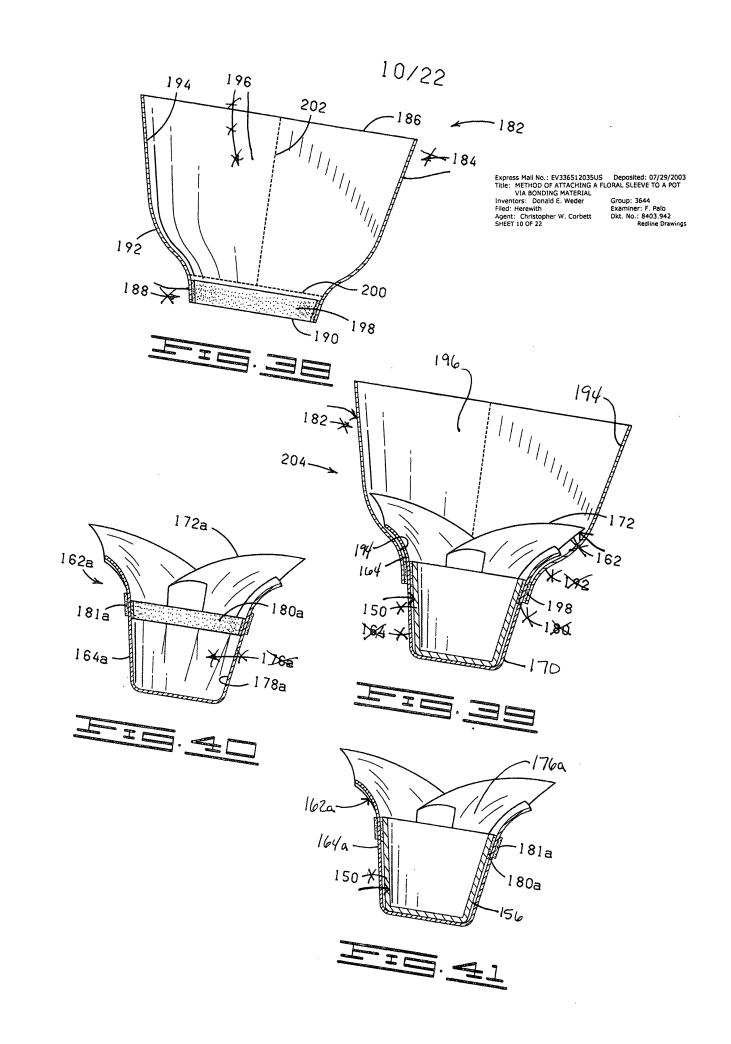

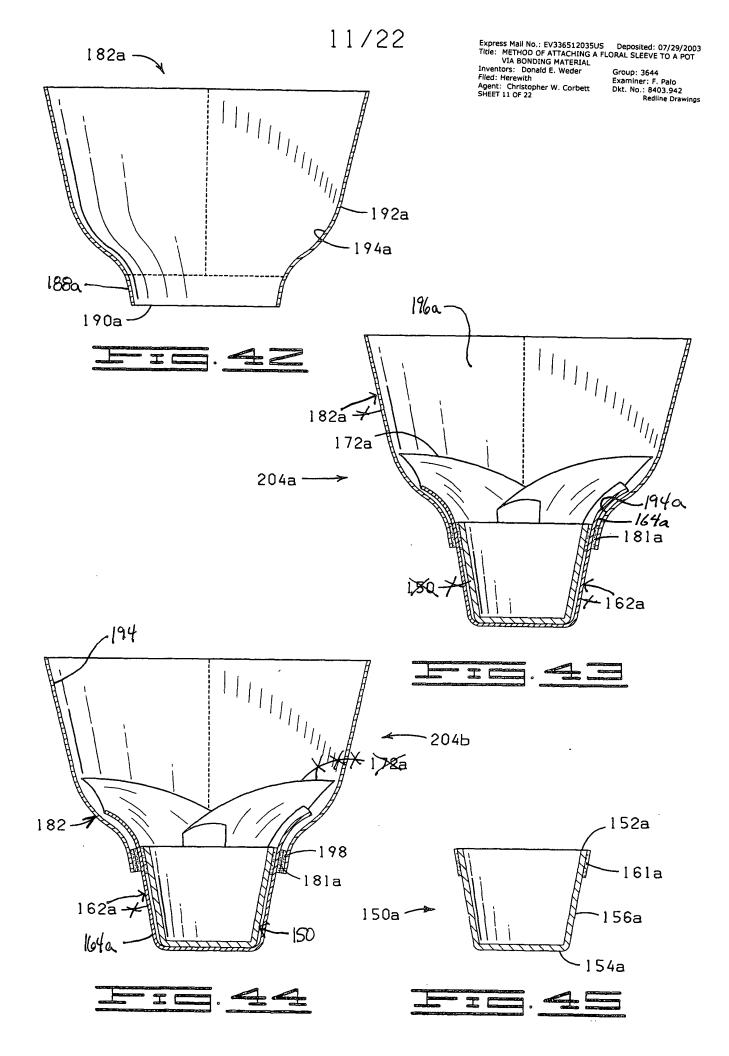


Express Mail No.: EV336512035US Deposited: 07/29/2003
Title: METHOD OF ATTACHING A FLORAL SLEEVE TO A POT VIA BONDING MATERIAL Inventors: Donald E. Weder Filed: Herewith Agent: Christopher W. Corbett SHEET 12 OF 22 Redline Drawings

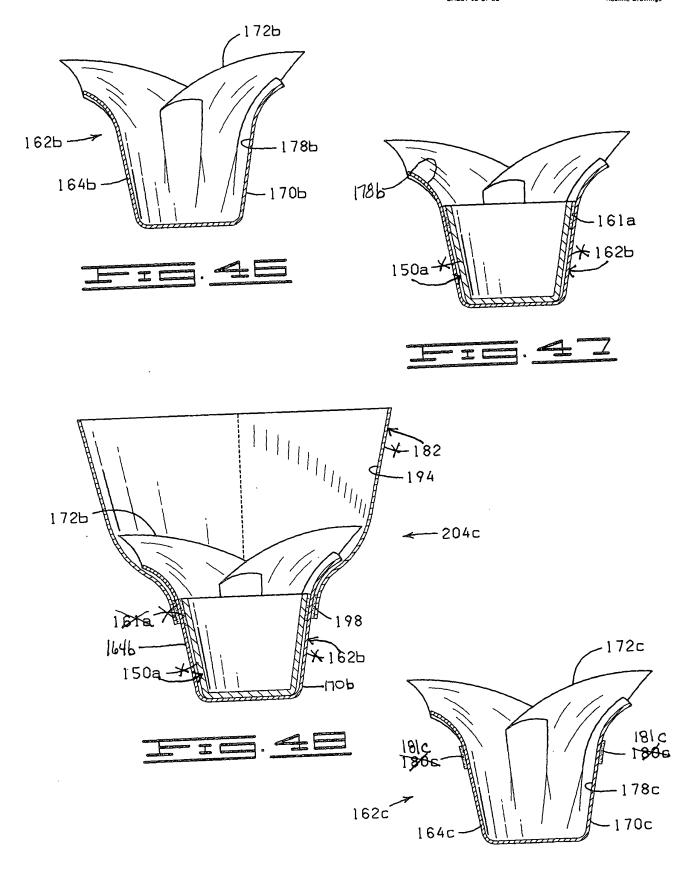


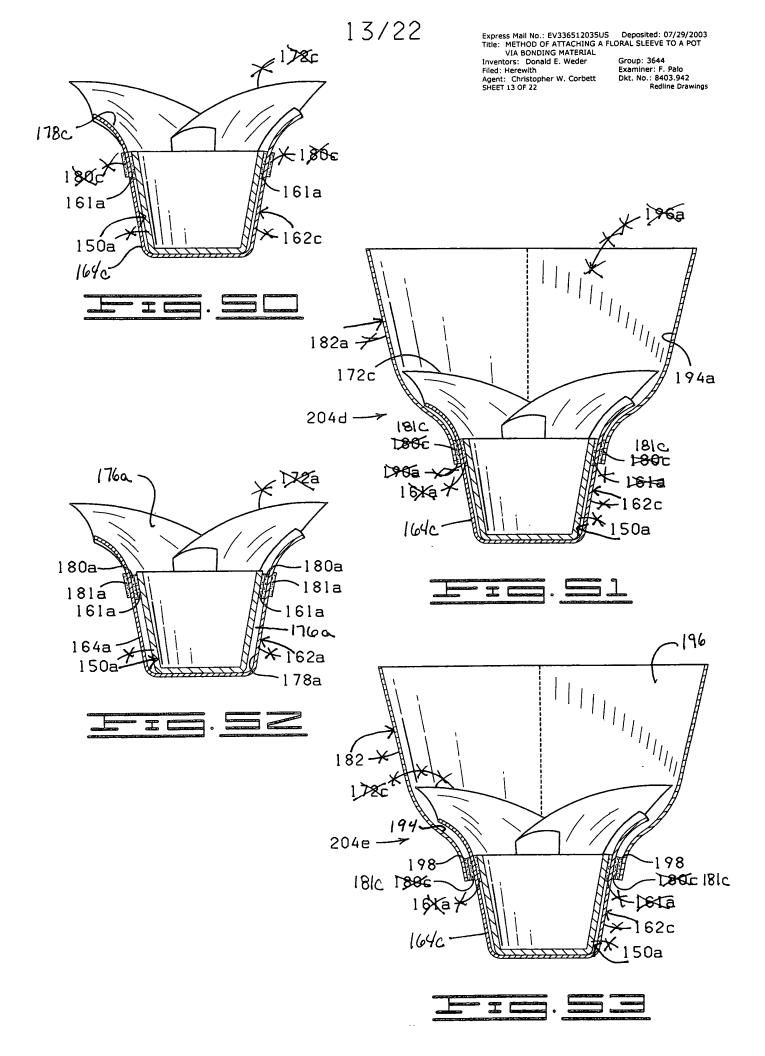


Express Mail No.: EV336512035US Deposited: 07/29/2003
Title: METHOD OF ATTACHING A FLORAL SLEEVE TO A POT
VIA BONDING MATERIAL
Inventors: Donald E. Weder
Filed: Herewith
Agent: Christopher W. Corbett
SHEET 14 OF 22 Redline Drawings

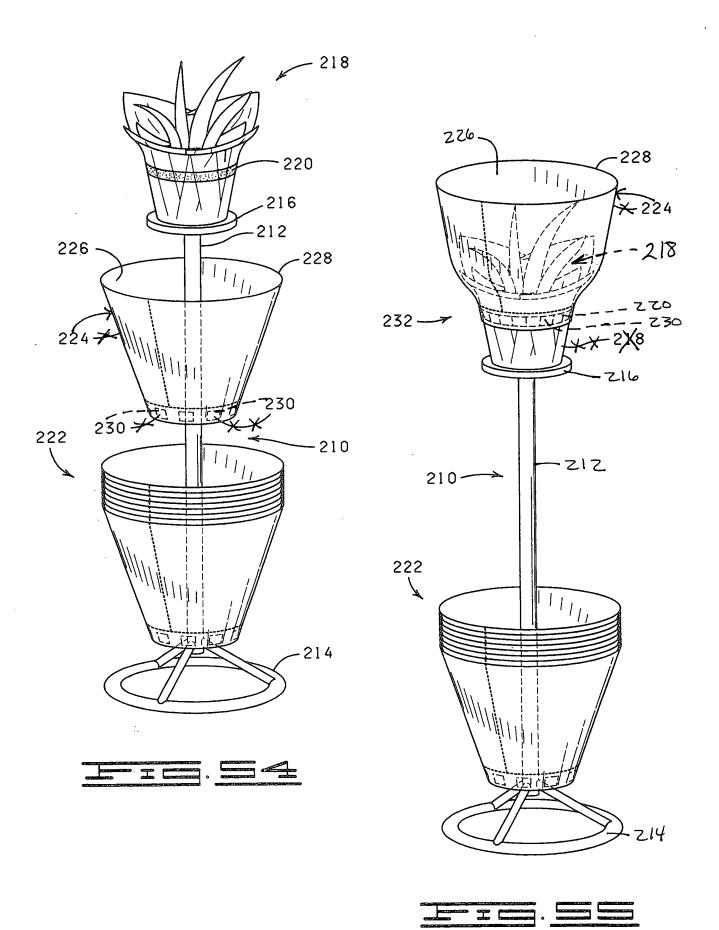



Express Mail No.: EV336512035US Deposited: 07/29/2003
Title: METHOD OF ATTACHING A FLORAL SLEEVE TO A POT
VIA BONDING MATERIAL
Inventors: Donald E. Weder
Filed: Herewith
Agent: Christopher W. Corbett
SHEET 15 OF 22 Redline Drawings

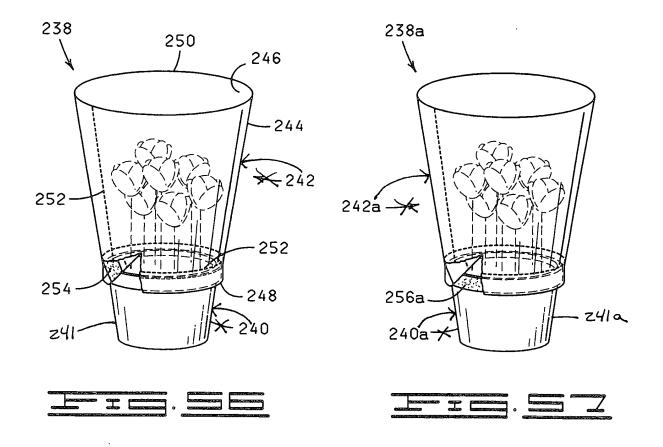


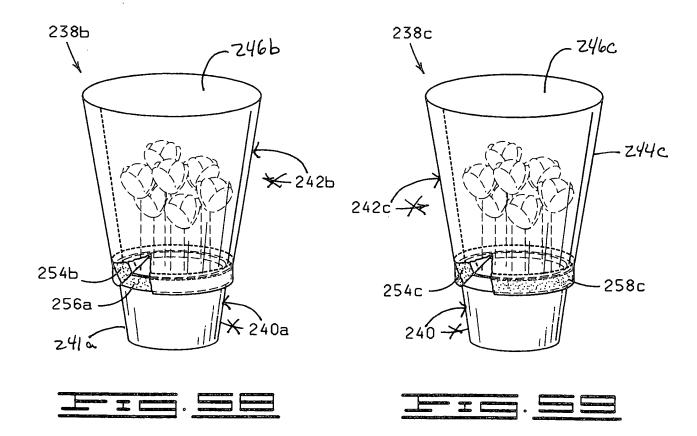


Express Mail No.: EV336512035US Deposited: 07/29/2003
Title: METHOD OF ATTACHING A FLORAL SLEEVE TO A POT
VIA BONDING MATERIAL
Inventors: Donald E. Weder
Filed: Herewith
Agent: Christopher W. Corbett
SHEET 16 OF 22 Redline Drawings

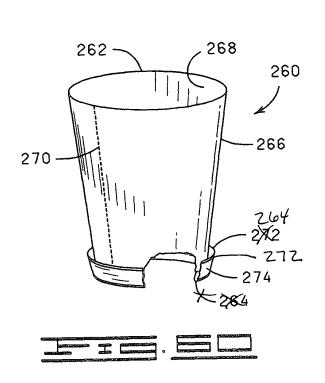


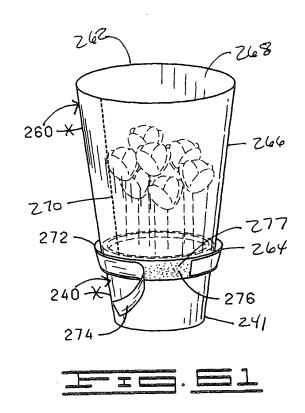


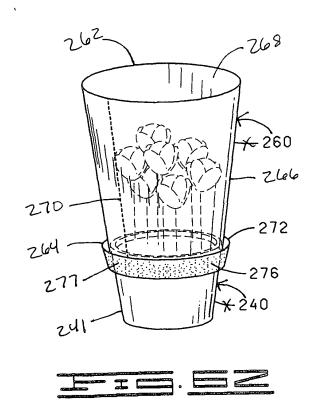

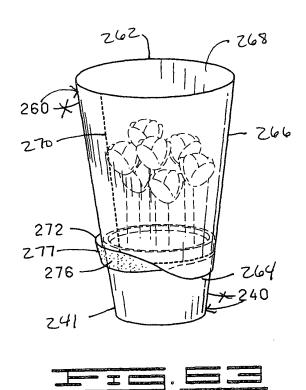

Express Mail No.: EV336512035US Deposited: 07/29/2003
Title: METHOD OF ATTACHING A FLORAL SLEEVE TO A POT
VIA BONDING MATERIAL
Inventors: Donald E. Weder
Filed: Herewith
Agent: Christopher W. Corbett
SHEET 17 OF 22 Redline Drawings

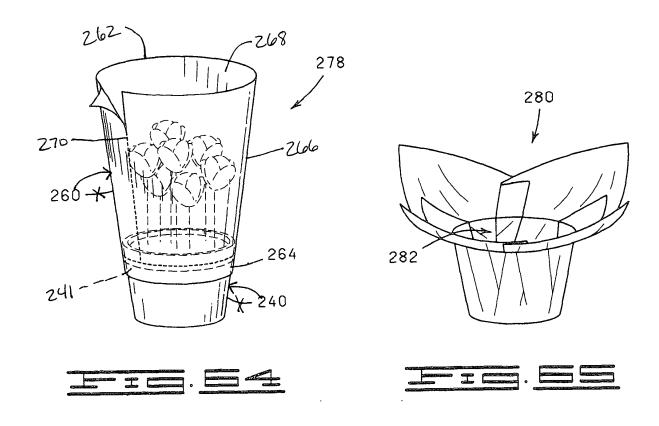

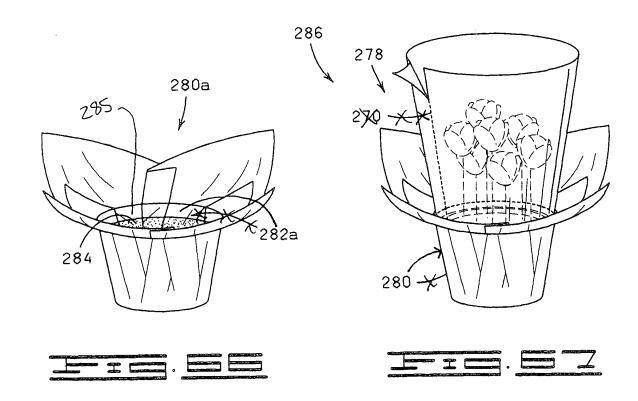

Express Mail No.: EV336512035US Deposited: 07/29/2003
Title: METHOD OF ATTACHING A FLORAL SLEEVE TO A POT VIA BONDING MATERIAL
Inventors: Donald E. Weder Filed: Herewith Agent: Christopher W. Corbett SHEET 19 OF 22 Redline Drawings

